

**"AS-BUILT" ACCEPTANCE PLAN
CANDLEWOOD DRIVE
MEDWAY, MA.**

Prepared **MARVIN DEVELOPMENT CORP.**
For: **707 MAIN STREET
MILLIS, MA. 02054**

Scale: **AS SHOWN** Date: **JANUARY 7, 1999**

**ENGINEERING SURVEYING & PLANNING
ASSOCIATES**

60 MAIN STREET, SUITE 200
MEDWAY, MA 02055
(508) 555-7000



Sheet 1 of 2

I HEREBY CERTIFY THAT THE PROPERTY LINES SHOWN ON THIS PLAN ARE THE LINES DIVIDING EXISTING OWNERSHIPS, AND THE LINES OF THE STREET AND WAYS SHOWN ARE THOSE OF PUBLIC OR PRIVATE STREETS OR WAYS ALREADY ESTABLISHED, AND THAT NO NEW LINES FOR DIVISION OF EXISTING OWNERSHIP OR FOR NEW WAYS ARE SHOWN.

1/7/99 DATE Francis X. Desimone 17032
FRANCIS X. DESIMONE R.L.S.

I CERTIFY THAT THIS PLAN SHOWS THE ACTUAL AS-BUILT LOCATIONS, PROFILES, AND ELEVATIONS OF ROADWAY, DRAINAGE STRUCTURES, AND UTILITIES BASED UPON A FIELD SURVEY.

1/7/99 DATE Francis X. Desimone 17032
FRANCIS X. DESIMONE R.L.S.

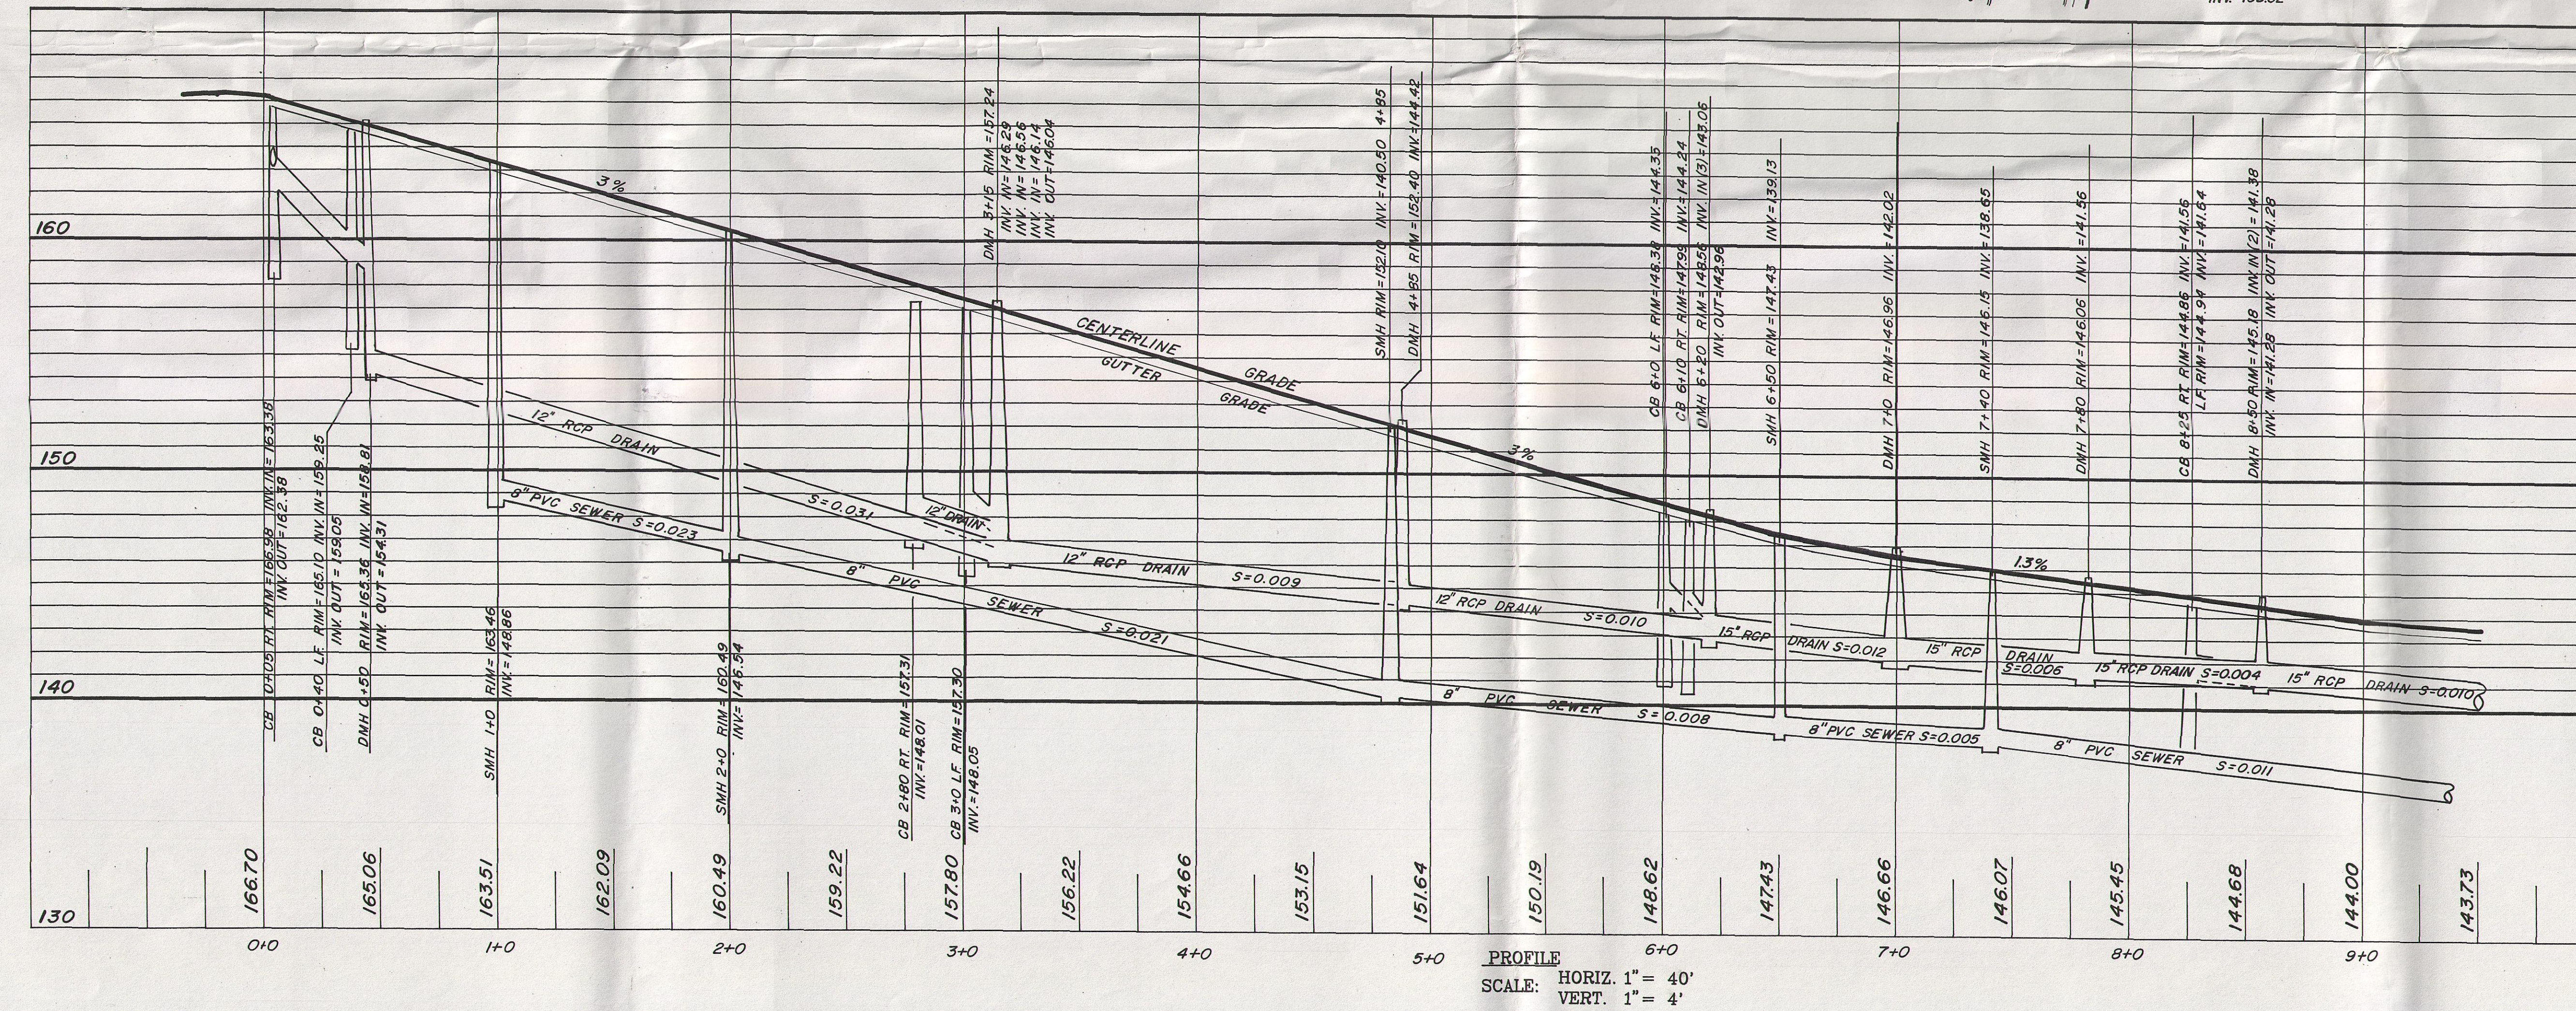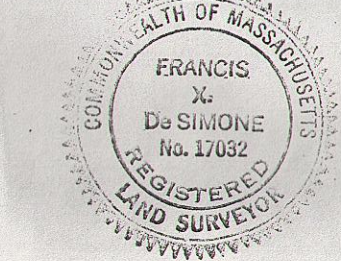


**MEDWAY
PLANNING BOARD**

DATE: _____

**MEDWAY
BOARD OF SELECTMEN**

DATE: _____

LOCATION OF ALL UNDERGROUND UTILITIES SHOWN HEREON ARE APPROXIMATE AND ARE BASED ON FIELD LOCATION OF ALL VISIBLE STRUCTURES. ALL CONTRACTORS MUST NOTIFY LOCAL UTILITY COMPANIES AND CALL DIG-SAFE AT 1-888-344-7233 A MINIMUM OF THREE BUSINESS DAYS PRIOR TO ANY EXCAVATION WORK.

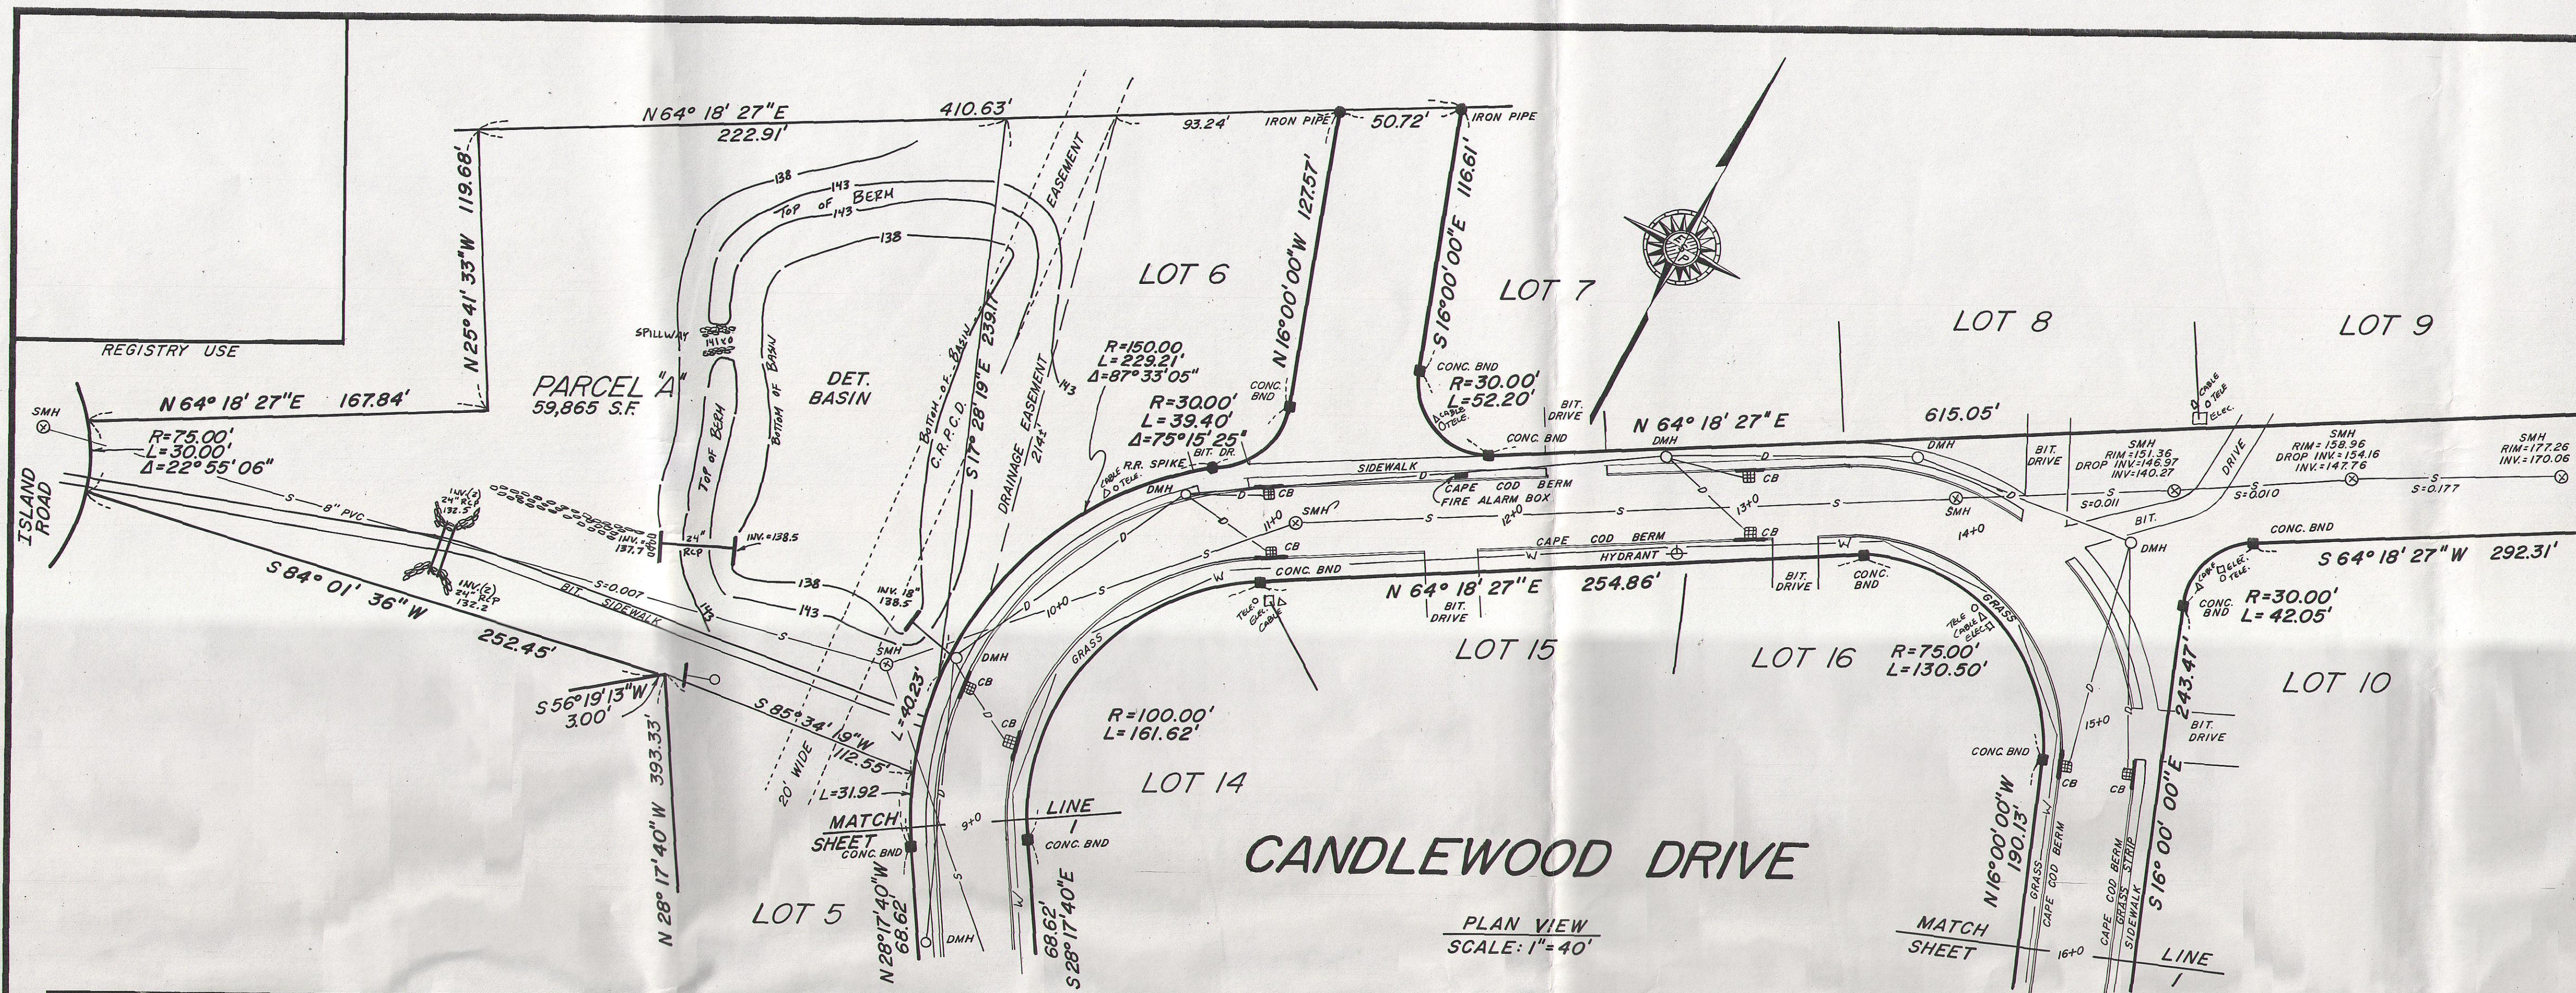

"AS-BUILT" ACCEPTANCE PLAN
CANDLEWOOD DRIVE
MEDWAY, MA.

Prepared **MARVIN DEVELOPMENT CORP.**
For: **707 MAIN STREET**
MILLIS, MA. 02054

Scale: **AS SHOWN** Date: **JANUARY 7, 1999**

E. ENGINEERING SURVEYING & PLANNING ASSOCIATES
99 MAIN STREET, SUITE 203
MEDWAY, MA 02053
(508) 533-7858



Sheet 2 of 2

I HEREBY CERTIFY THAT THE PROPERTY LINES SHOWN ON THIS PLAN ARE THE LINES DIVIDING EXISTING OWNERSHIPS, AND THE LINES OF THE STREET AND WAYS SHOWN ARE THOSE OF PUBLIC OR PRIVATE STREETS OR WAYS ALREADY ESTABLISHED, AND THAT NO NEW LINES FOR DIVISION OF EXISTING OWNERSHIP OR FOR NEW WAYS ARE SHOWN.

1/7/99 *Francis X. Desimone* 17032
DATE FRANCIS X. DESIMONE R.L.S.

I CERTIFY THAT THIS PLAN SHOWS THE ACTUAL AS-BUILT LOCATIONS, PROFILES, AND ELEVATIONS OF ROADWAY, DRAINAGE STRUCTURES, AND UTILITIES BASED UPON A FIELD SURVEY.

1/7/99 *Francis X. Desimone* 17032
DATE FRANCIS X. DESIMONE R.L.S.

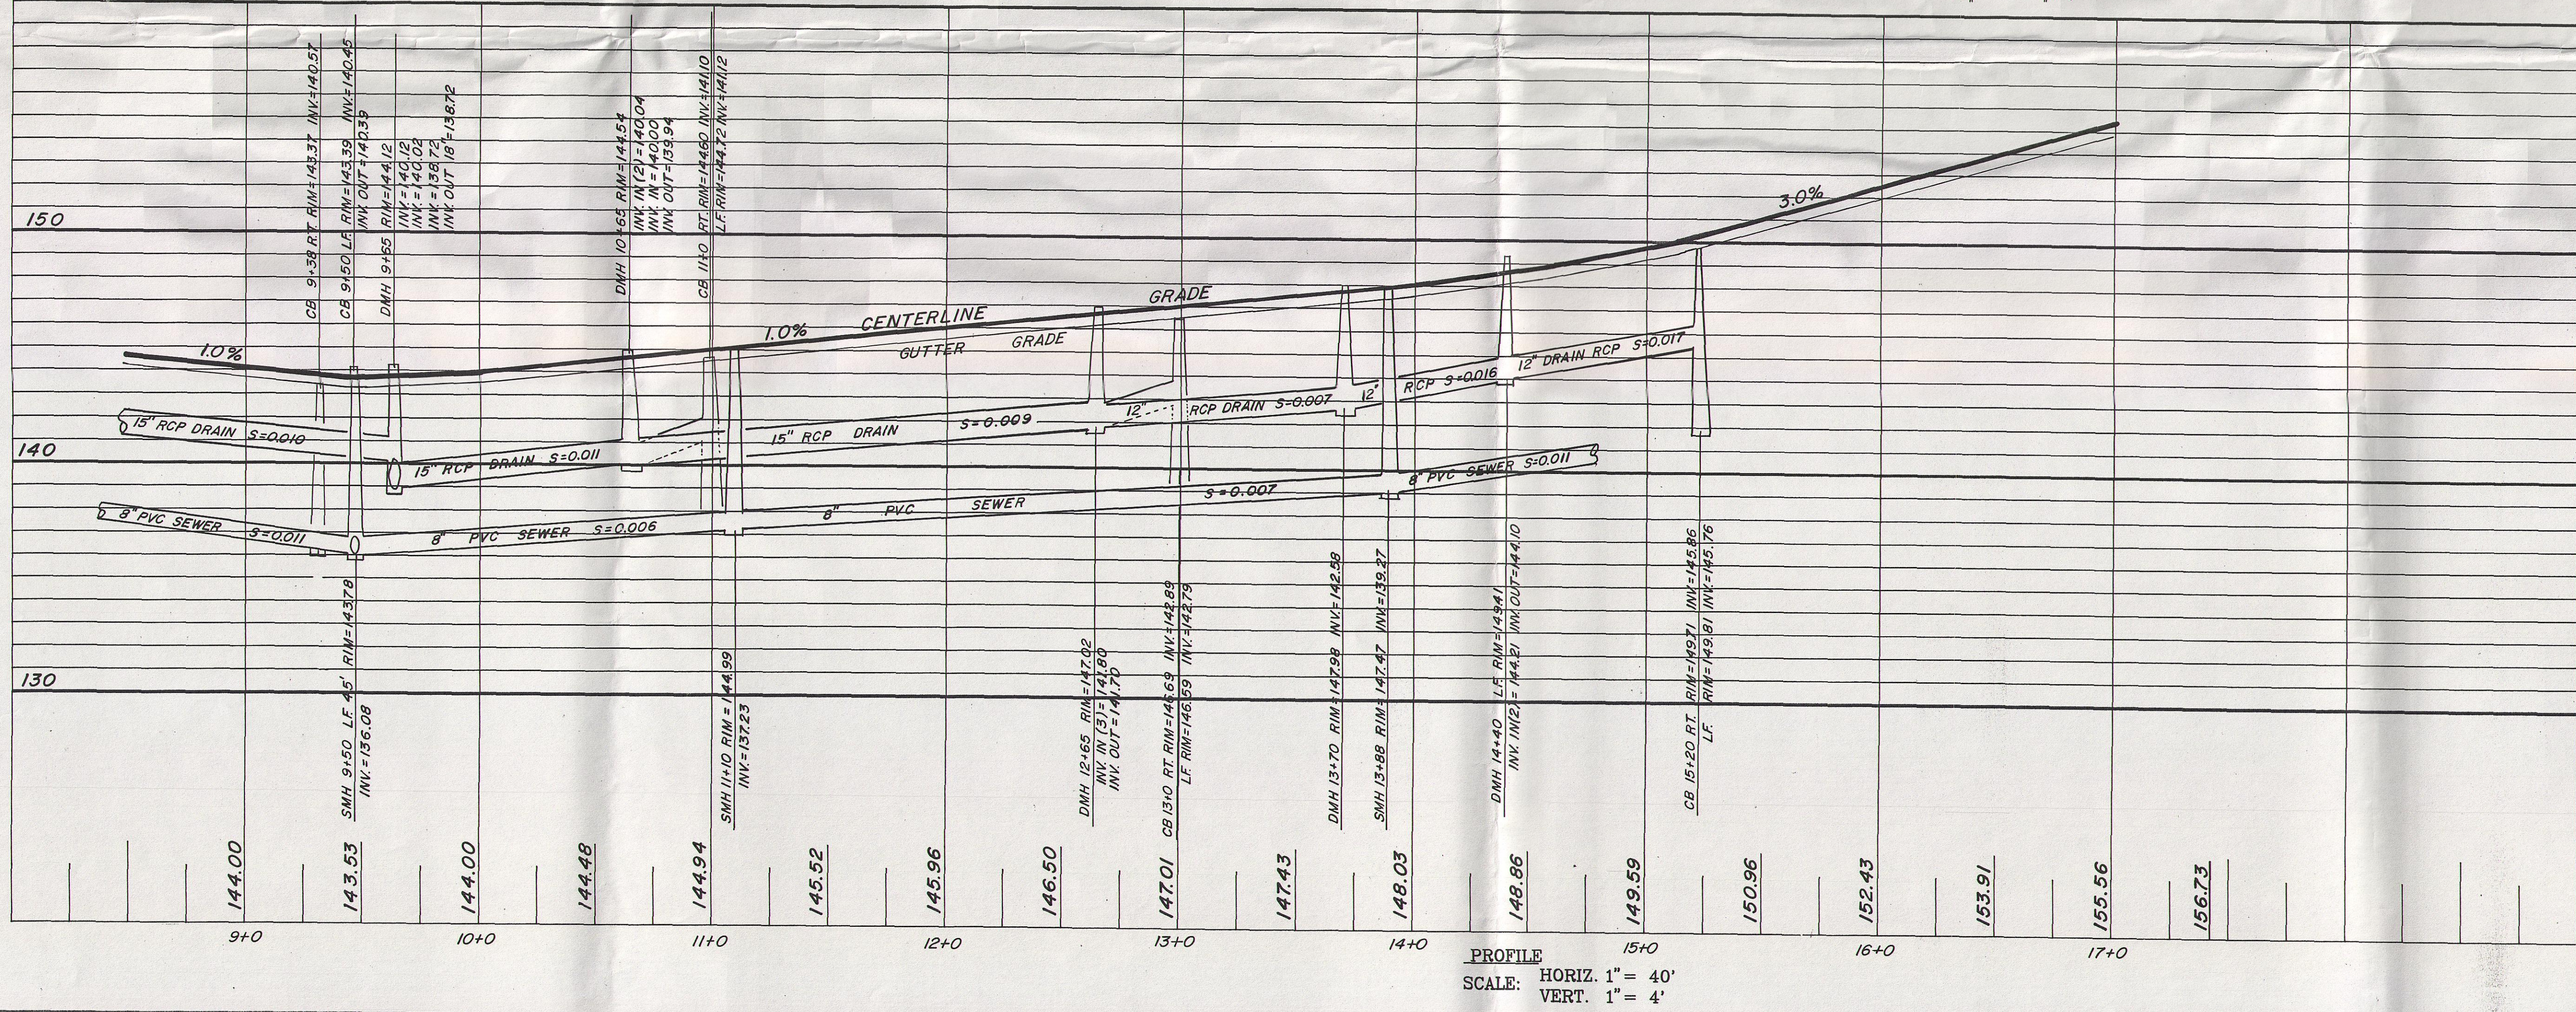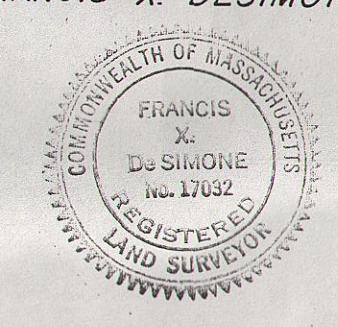

MEDWAY PLANNING BOARD

DATE: _____

MEDWAY BOARD OF SELECTMEN

DATE: _____

LOCATION OF ALL UNDERGROUND UTILITIES SHOWN HEREON ARE APPROXIMATE AND ARE BASED ON FIELD LOCATION OF ALL VISIBLE STRUCTURES. ALL CONTRACTORS MUST NOTIFY LOCAL UTILITY COMPANIES AND CALL DIG-SAFE AT 1-888-344-7233 A MINIMUM OF THREE BUSINESS DAYS PRIOR TO ANY EXCAVATION WORK.