





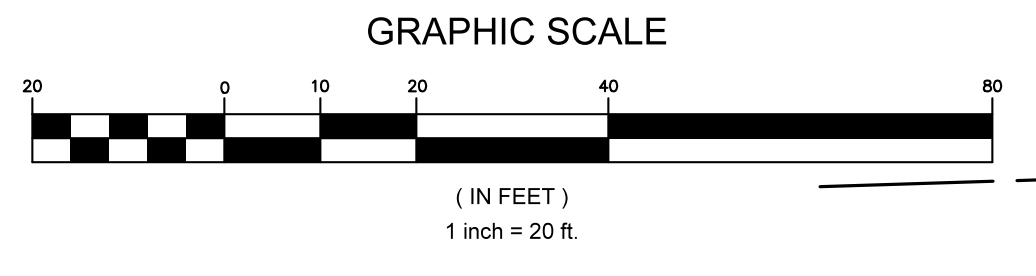

### LEGEND

PROPERTY LINE	---
ABUTTING PROPERTY LINE	---
IRON PIPE	—○—
MONUMENT	—□—
UTILITY POLE	—○—
FIRE HYDRANT	—●—
WATER GATE	—W.G.—
WATER LINE	—W—
GAS VALVE	—G.G.—
GAS LINE	—G—
CATCH BASIN (CB)	—CB—
DRAINAGE MAINHOLE	—DMH—
DRAINAGE LINE	—D—
SEWER MANHOLE (SMH)	—SMH—
SEWER LINE	—S—
OVERHEAD ELECTRIC	—OH—
UNDERGROUND ELECTRIC	—UG—
FENCE	—X—
EDGE OF WETLANDS	—W—
WETLAND SYMBOL	—W—
WETLAND BUFFER	—WB—
TC	TOP OF CURB
BC	BOTTOM OF CURB
FES	FLARED END SECTION
RCP	REINFORCED CONCRETE PIPE
L.F.	LINEAR FEET

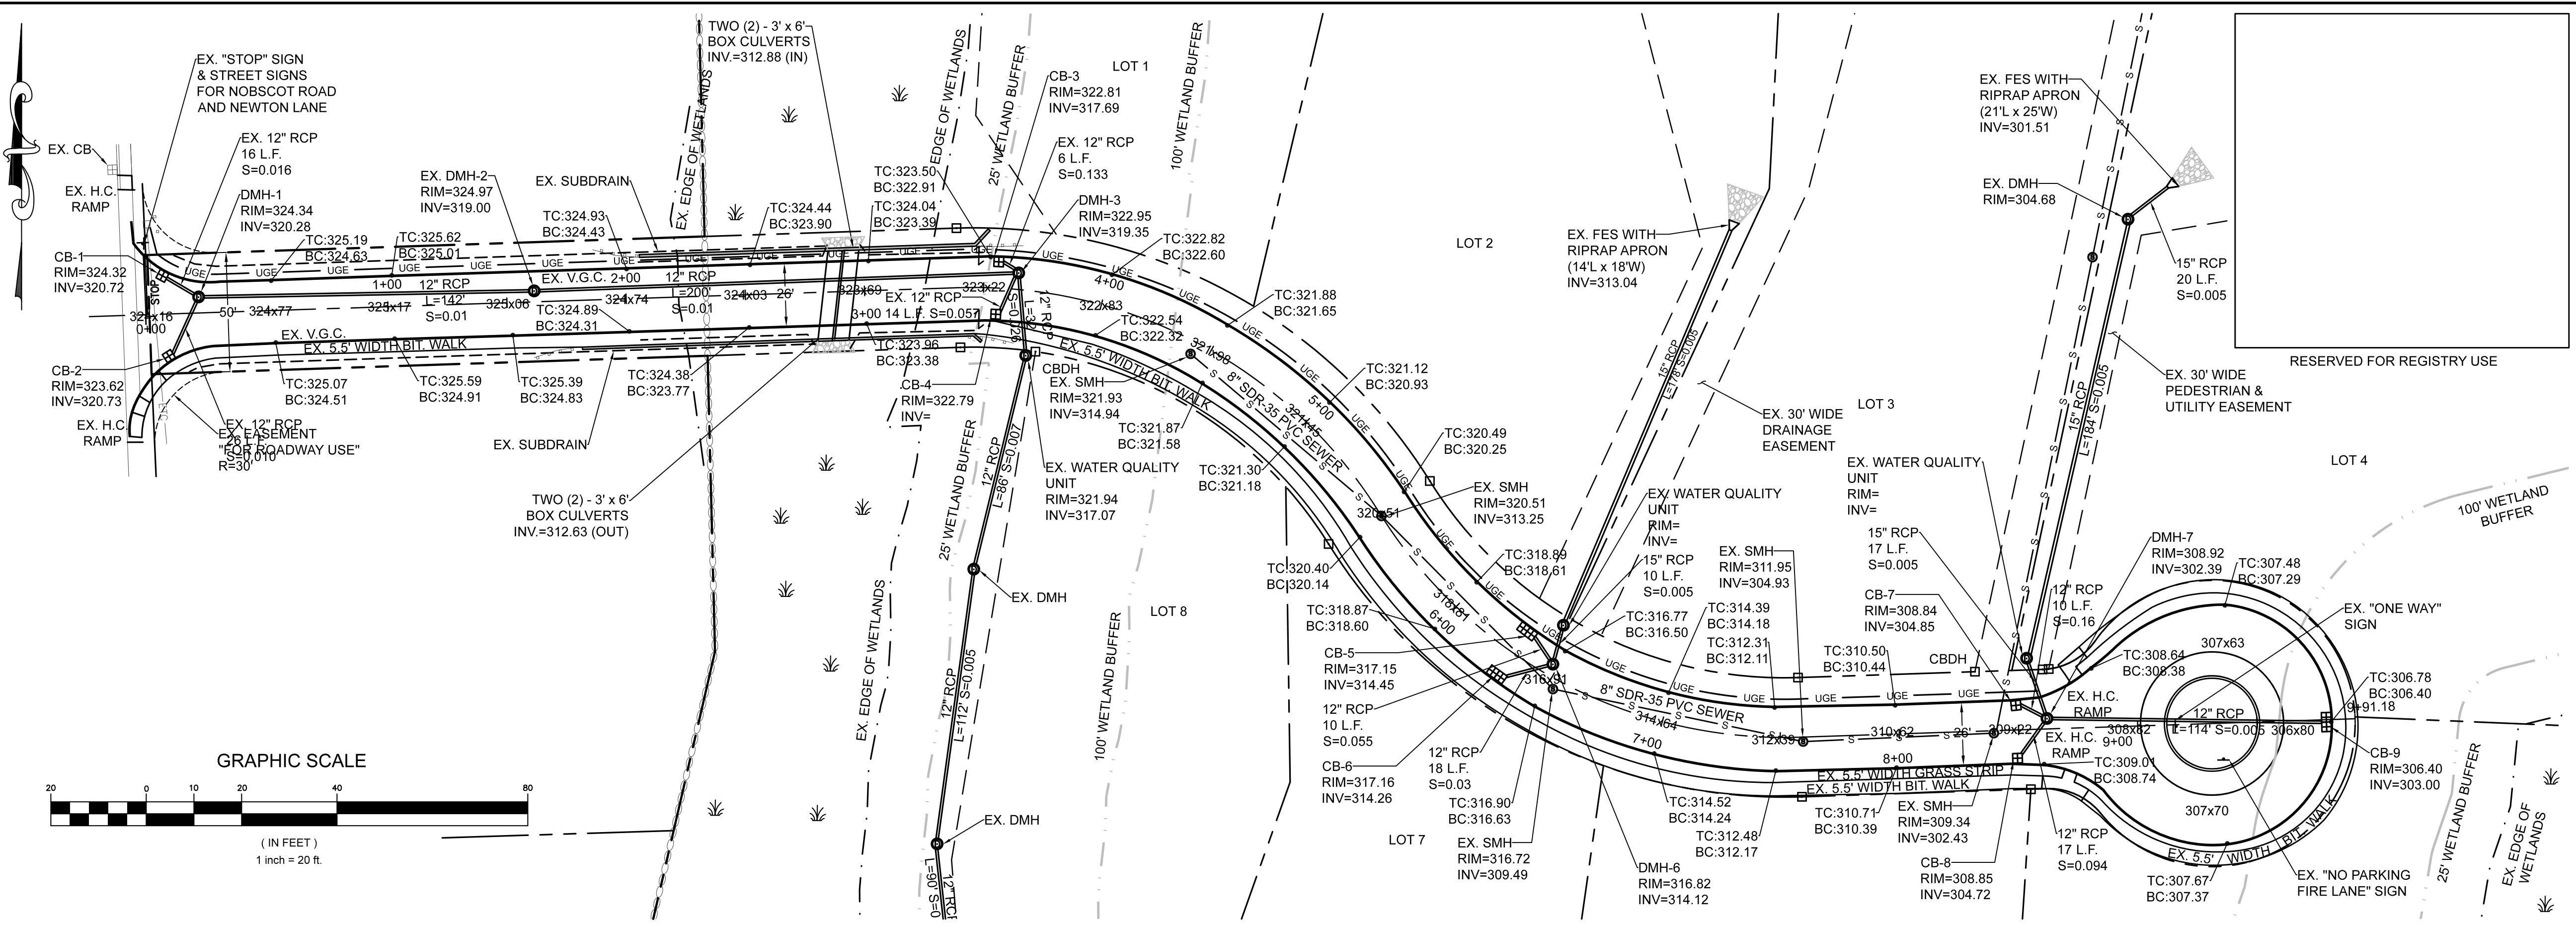


TOWN OF MEDWAY PLANNING & ECONOMIC DEVELOPMENT BOARD

DATE - AS-BUILT PLAN APPROVAL

DATE - ROAD LAYOUT ACCEPTANCE APPROVAL

TOWN OF MEDWAY SELECTMAN

DATE - ROAD LAYOUT ACCEPTANCE APPROVED

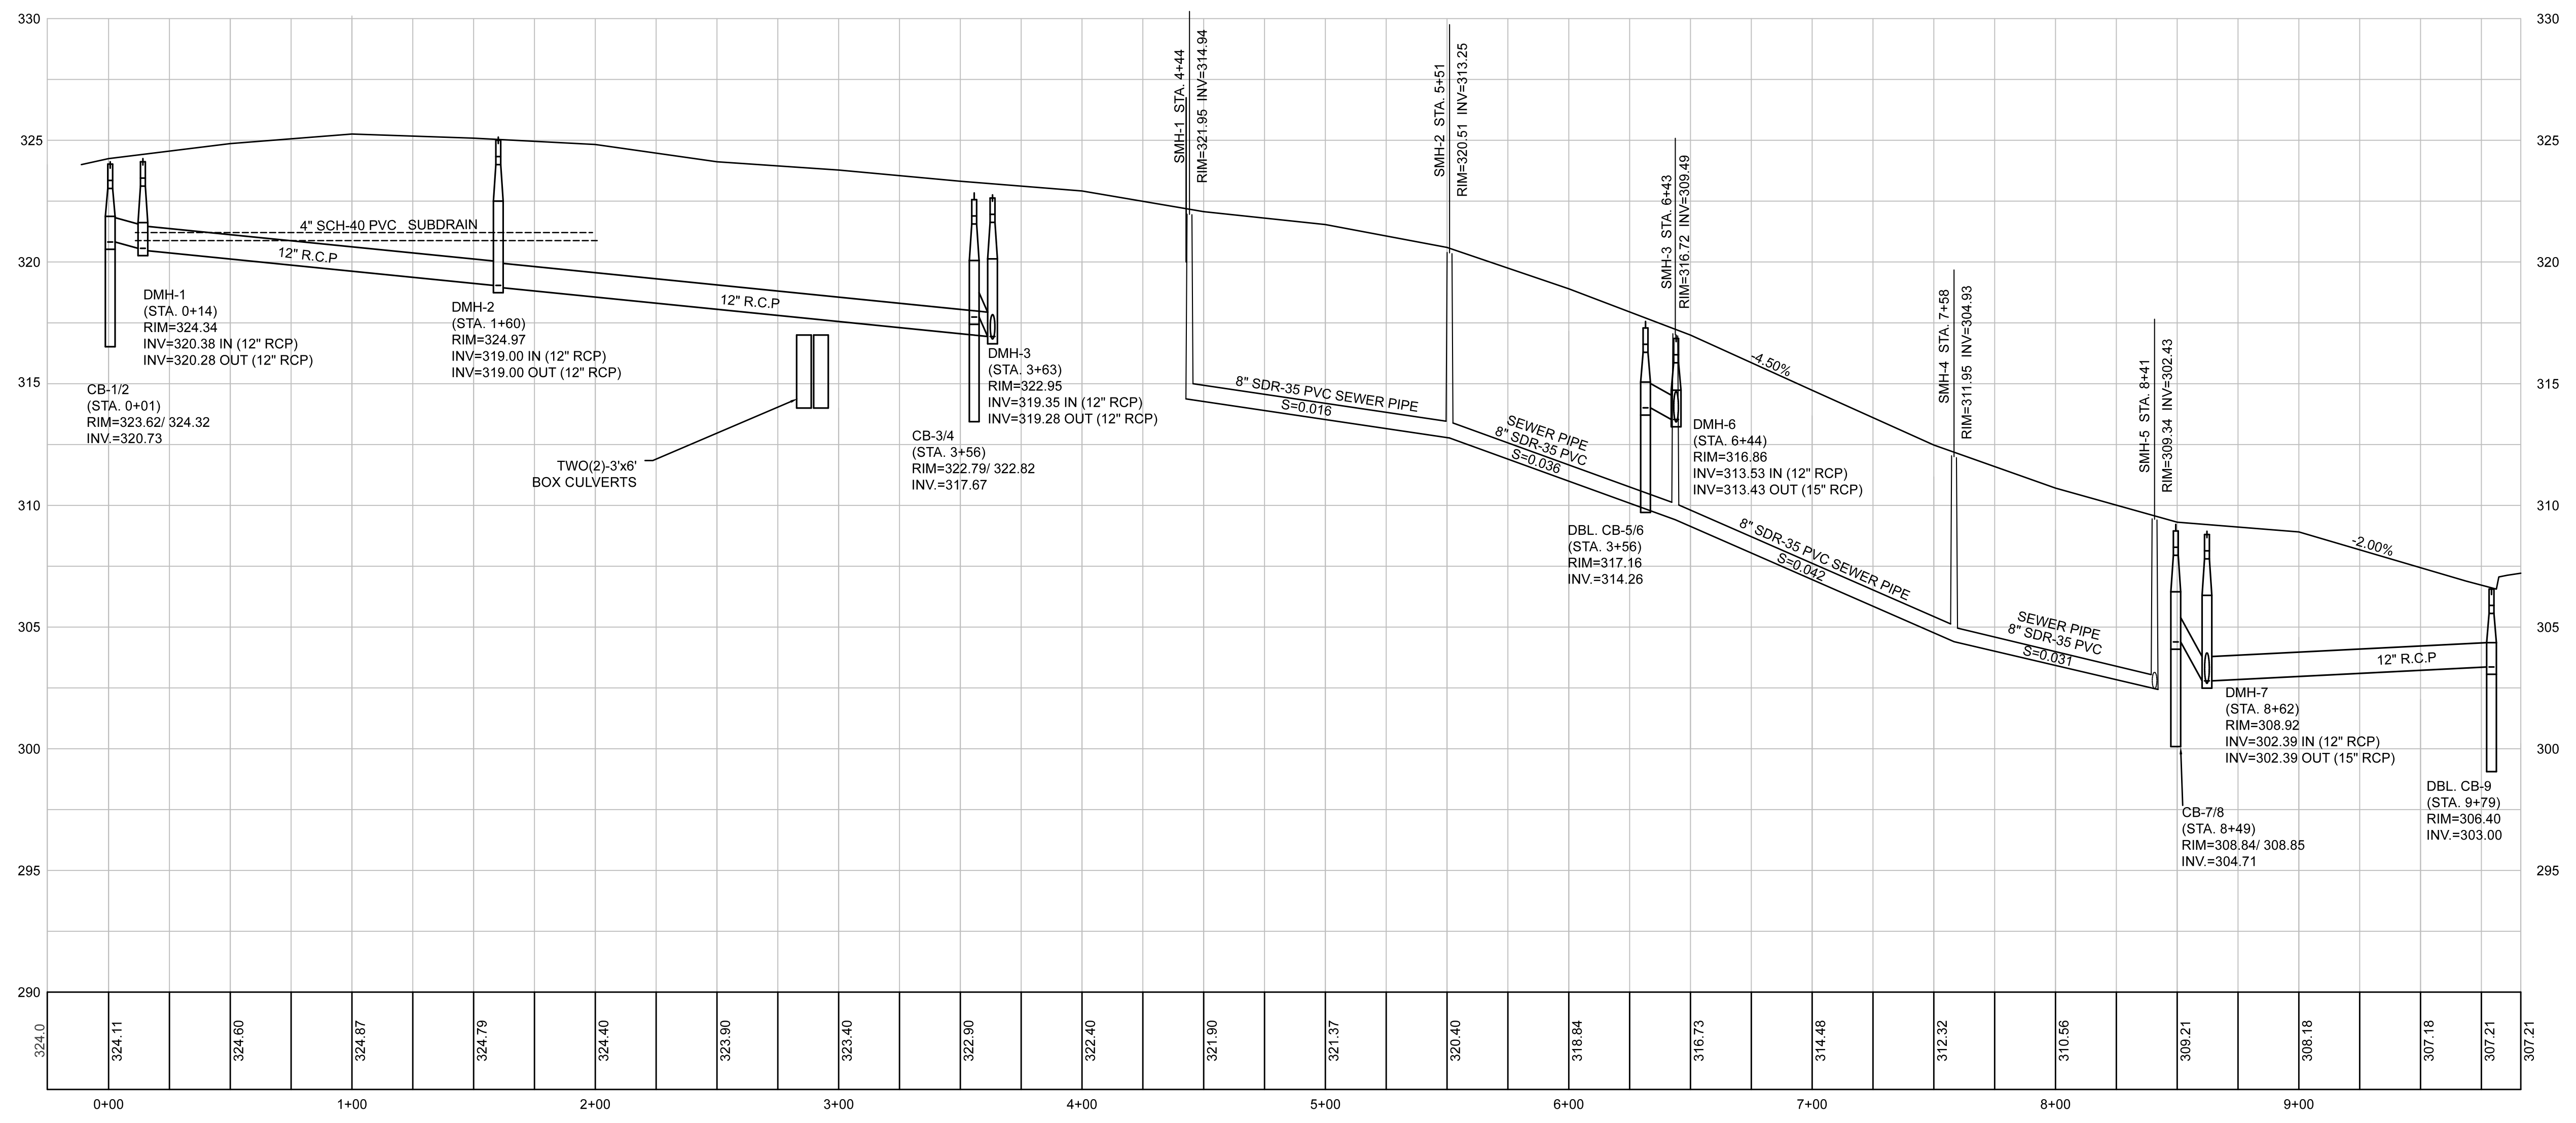

1) "I HEREBY CERTIFY THAT THIS PLAN SHOWS THE ACTUAL AS-BUILT LOCATIONS, PROFILES AND ELEVATIONS OF THE ROADWAYS, DRAINAGE FACILITIES AND UTILITIES, BASED UPON A FIELD SURVEY PERFORMED BETWEEN JUNE 14, 2011 & NOVEMBER 30, 2011."

2) "THE STREET (OR WAY THEREOF) AS LAID OUT AND THE BOUNDS HAVE BEEN SET AS SHOWN ON THE PLAN."

3) "I CERTIFY THAT THIS PLAN IS PREPARED IN CONFORMANCE WITH THE "RULES AND REGULATIONS OF THE REGISTERS OF DEEDS OF THE COMMONWEALTH OF MASSACHUSETTS."

DANIELA A. O'DRISCOLL, PLS DATE

DIG SAFE NOTE (1-888-344-7233): CONTRACTOR REQUIRED TO NOTIFY "DIG SAFE" 72 HOURS PRIOR TO ANY ON-SITE EXCAVATION OR CONSTRUCTION AT 1-888-344-7233. CONTRACTOR SHALL ALSO NOTIFY LOCAL WATER AND SEWER DEPARTMENTS TO MARK OUT THEIR UTILITIES.

**PRELIMINARY PLAN**  
NOT FOR CONSTRUCTION PURPOSES  
1/19/2022

NO.	DATE	DESCRIPTION	BY	CHKD

RESERVED FOR REGISTRY USE

STREET ACCEPTANCE & AS-BUILT PLAN  
HARTNEY ACRES II  
NEWTON LANE  
MEDWAY, MA 02053

PAUL YORKIS  
159 MAIN STREET  
MEDWAY, MA 02053

ENGINEERING SERVICES ENVIRONMENTAL SERVICES  
67 Hall Road  
Sturbridge, MA 01560  
Phone: 774-241-0901  
fax: 774-241-0906

O'DRISCOLL  
LAND SURVEYING INC.  
LAND SURVEYING, GPS MAPPING, LAND CONSULTING  
46 COTTAGE STREET - MEDWAY, MASSACHUSETTS 02053 (508) 533-3314

ISSUE DATE: 11/24/2021  
DRAWN BY: RL CHECKED BY: DTF  
SCALE: 1"=40'  
PROJECT NO.: 2020-102

NEWTON LANE AS-BUILT PLAN  
C-3.0