


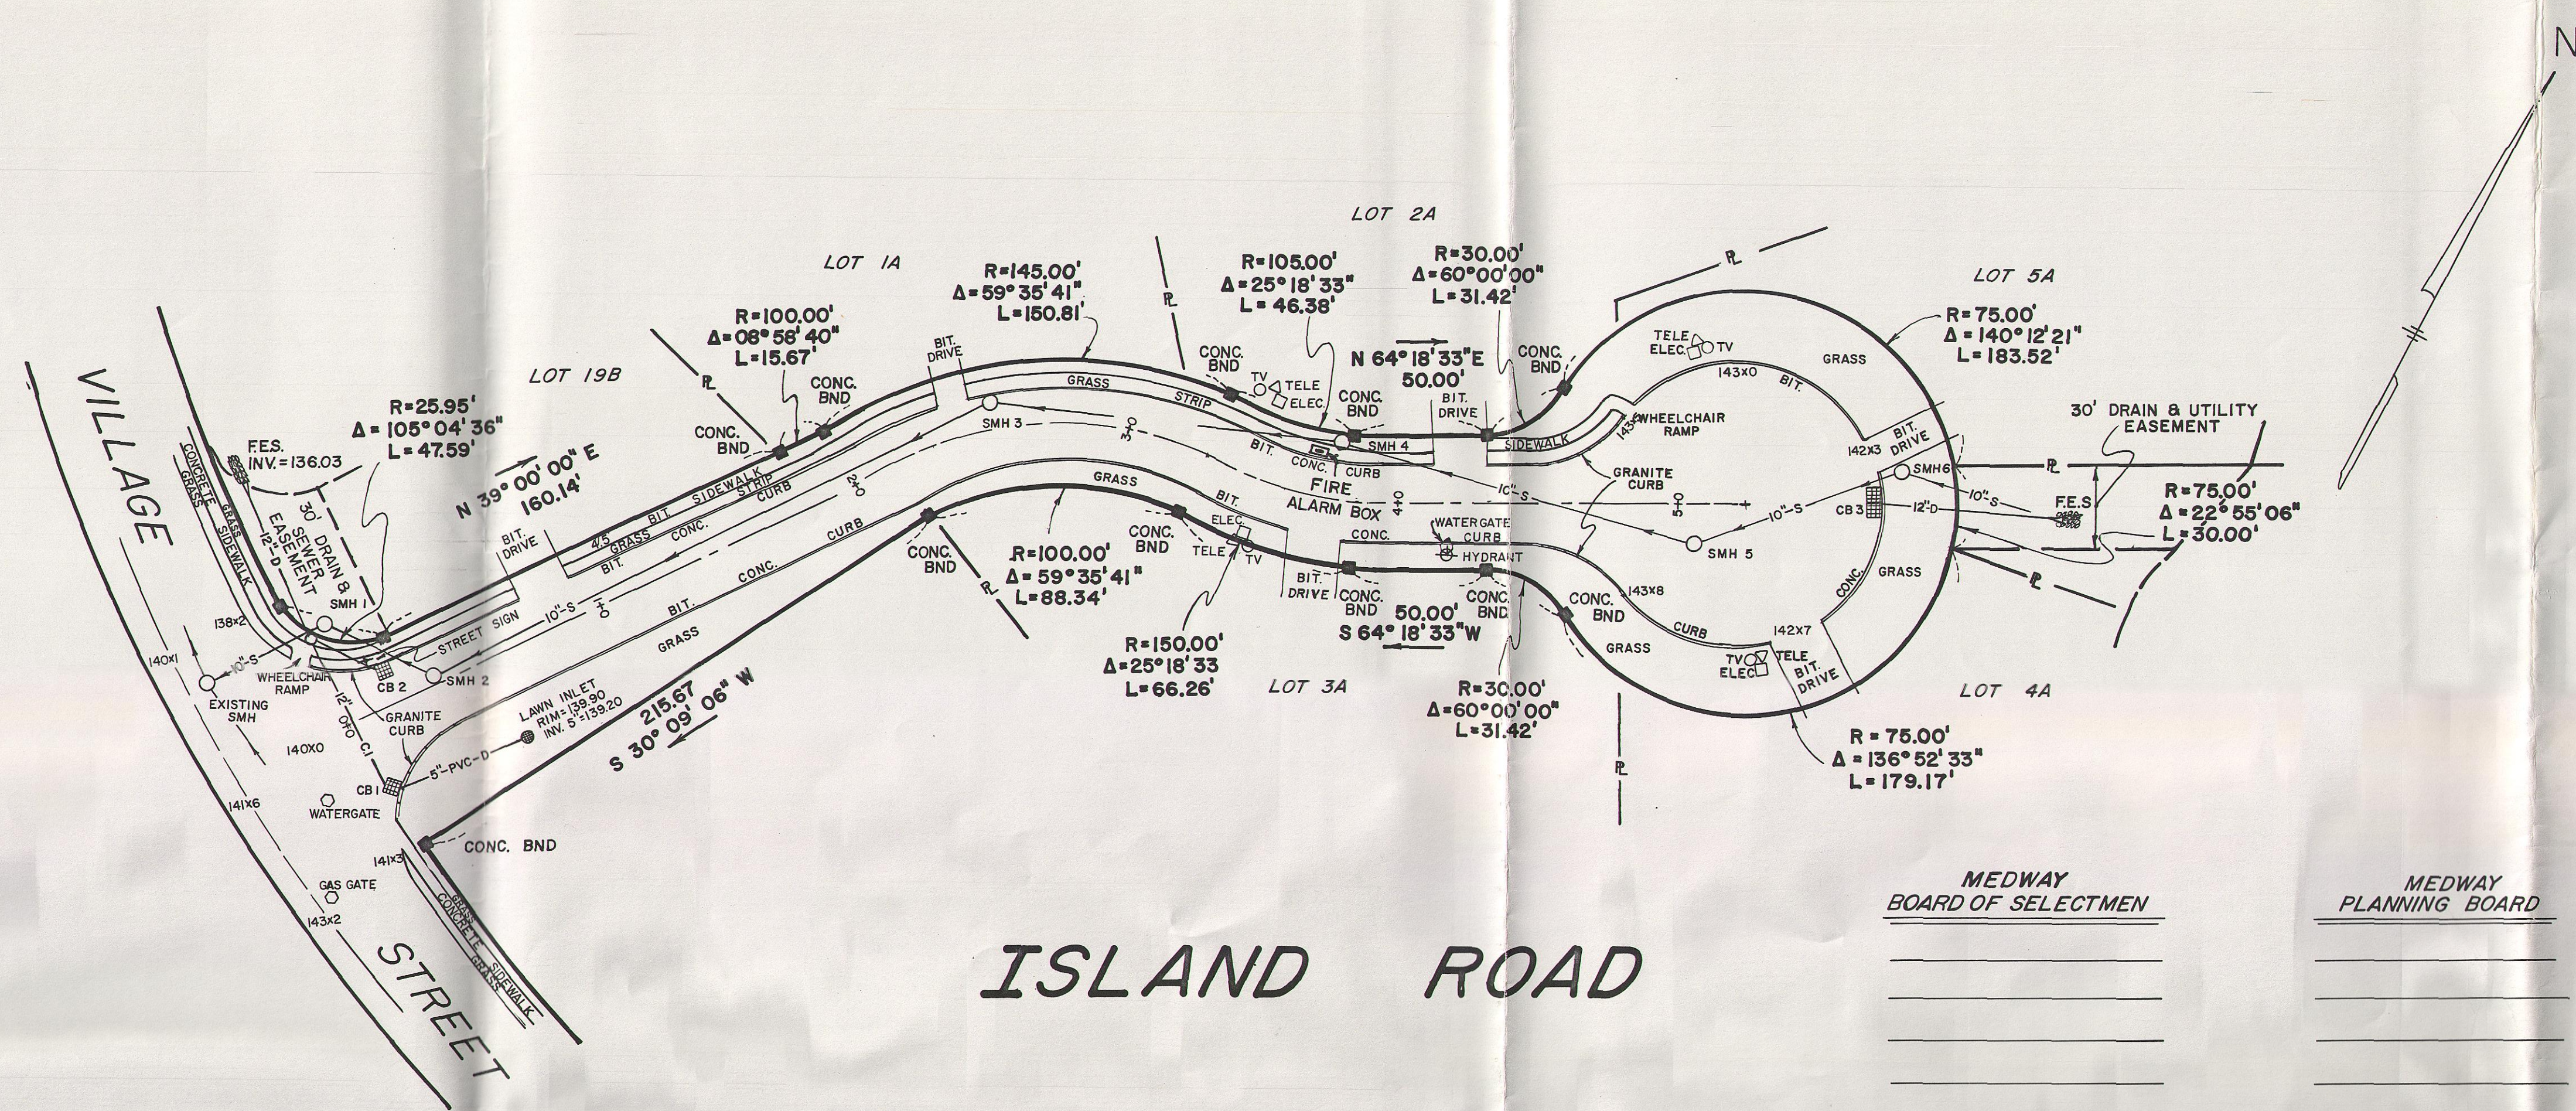

SUBDIVISION AS-BUILT
" ISLAND ROAD "
MEDWAY, MA.

Prepared For: MARVIN DEVELOPMENT INC.
707 MAIN STREET
MILLIS, MA 02054

Scale: NOTED Date: 2/15/95 Revisions:

ENGINEERING SURVEYING & PLANNING ASSOCIATES
80 MAIN STREET SUITE 200 MEDWAY, MA 02053

Sheet 1 of 1

LOCATION OF ALL UNDERGROUND UTILITIES SHOWN HEREON ARE APPROXIMATE AND ARE BASED ON FIELD LOCATION OF ALL VISIBLE STRUCTURES, SUCH AS CATCH BASINS, MANHOLES, WATER GATES, ETC. IN ACCORDANCE WITH CHAPTER 82, SECTION 40, INCLUDING AMENDMENTS, ALL CONTRACTORS SHOULD NOTIFY IN WRITING ALL UTILITY COMPANIES AND CALL DIG-SAFE AT 1-800-322-4844 A MINIMUM OF 72 HOURS PRIOR TO ANY EXCAVATION WORK.

PROFILE SCALE
VERT. 1" = 4.0'
HORIZ. 1" = 40'

MEDWAY BOARD OF SELECTMEN

MEDWAY PLANNING BOARD

DATE: _____

DATE: _____

I CERTIFY THAT CONCRETE MONUMENTS HAVE BEEN SET AS SHOWN HEREON

2.17.95
DATE

Alexander Wzaleski
ALEXANDER WZALESKI

